




**WARNING**  
 BEWARE OF UNDERGROUND/OVERHEAD SERVICES  
 THE LOCATION OF SERVICES ARE APPROXIMATE ONLY  
 AND THEIR EXACT POSITION SHOULD BE PROVEN ON  
 SITE. NO GUARANTEE IS GIVEN THAT ALL EXISTING  
 SERVICES ARE SHOWN. SPECIAL CONSIDERATION  
 SHOULD BE GIVEN TO CONSTRUCTION PROCEDURES  
 UNDER OVERHEAD ELECTRICITY TRANSMISSION LINES.

3	AS CONSTRUCTED ISSUE	M.L.	18/06/20
2	LOT BOUNDARY OF 719 TO 720 MOVED WEST 0.9m. FSL, ESL AND CH UPDATED	M.L.	05/07/19
1	LOTS 708 TO 734 LAYOUT UPDATED. LOT NUMBERS UPDATED.	M.L.	24/06/19
0	DRAINAGE AND SEWER LAYOUT UPDATED.	M.L.	27/05/19
Rev	Amendments	Approved	Date

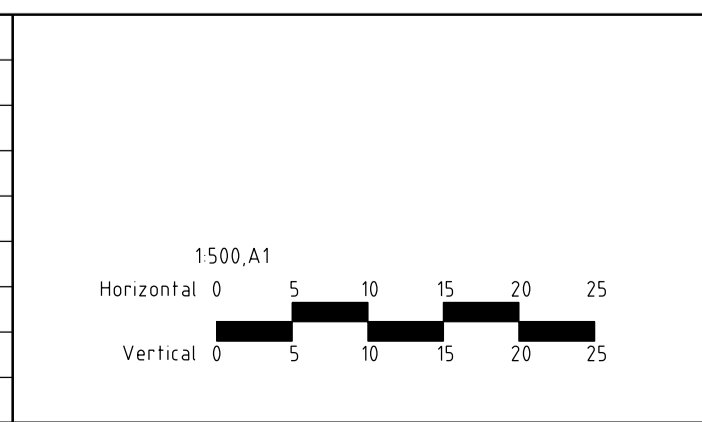

© Spiire Australia Pty Ltd All Rights Reserved  
 This document is produced by Spiire Australia Pty Ltd solely for the benefit of and use by the client in accordance with the terms of the retainer. Spiire Australia Pty Ltd does not and shall not assume any responsibility or liability whatsoever to any third party arising out of any use or reliance by third party on the content of this document.

**spiire**  
 spiire.com.au ABN 55 050 029 635

**FRASERS PROPERTY**  
 Designed: R. WEINBER  
 Authorised: M. LETSON  
 Checked: R. WEINBER  
 Date: 16/01/19

**MAMBOURIN ESTATE  
 STAGE 7  
 ROAD & DRAINAGE  
 FACE PLAN**  
 FRASER PROPERTY AUSTRALIA  
 WYNDHAM CITY COUNCIL  
**AS CONSTRUCTED** Drg No 305172R02 Rev 3